

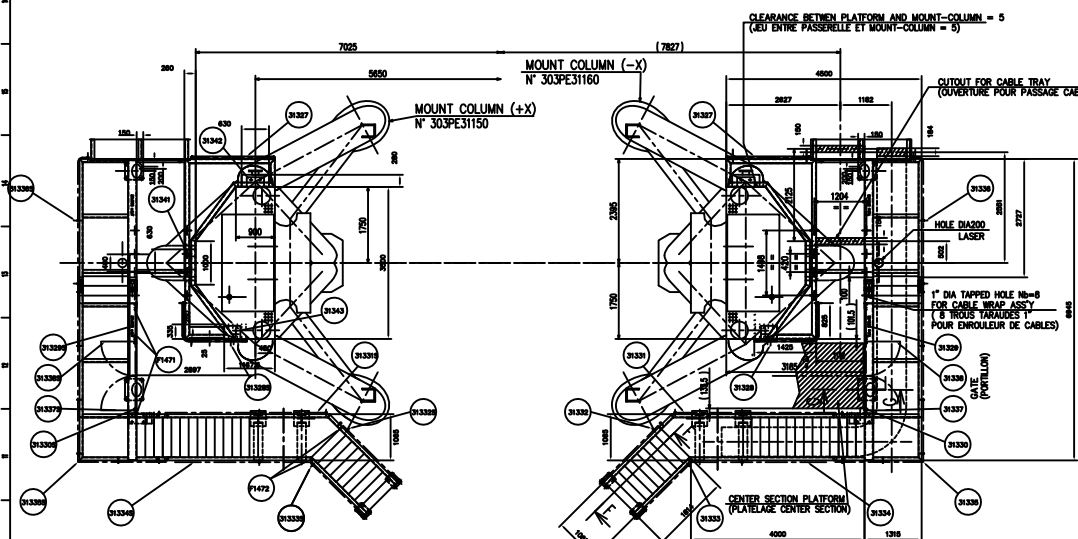
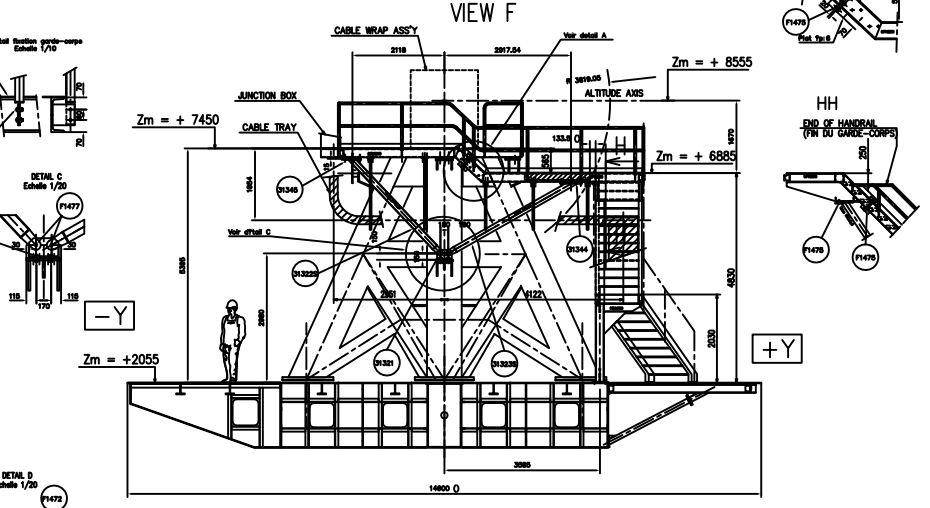


1/2 VIEW : FIXING ON MOUNT-COLUMN

1/2 VIEW : ENVELOPE DIMENSION OF THE PLATFORM

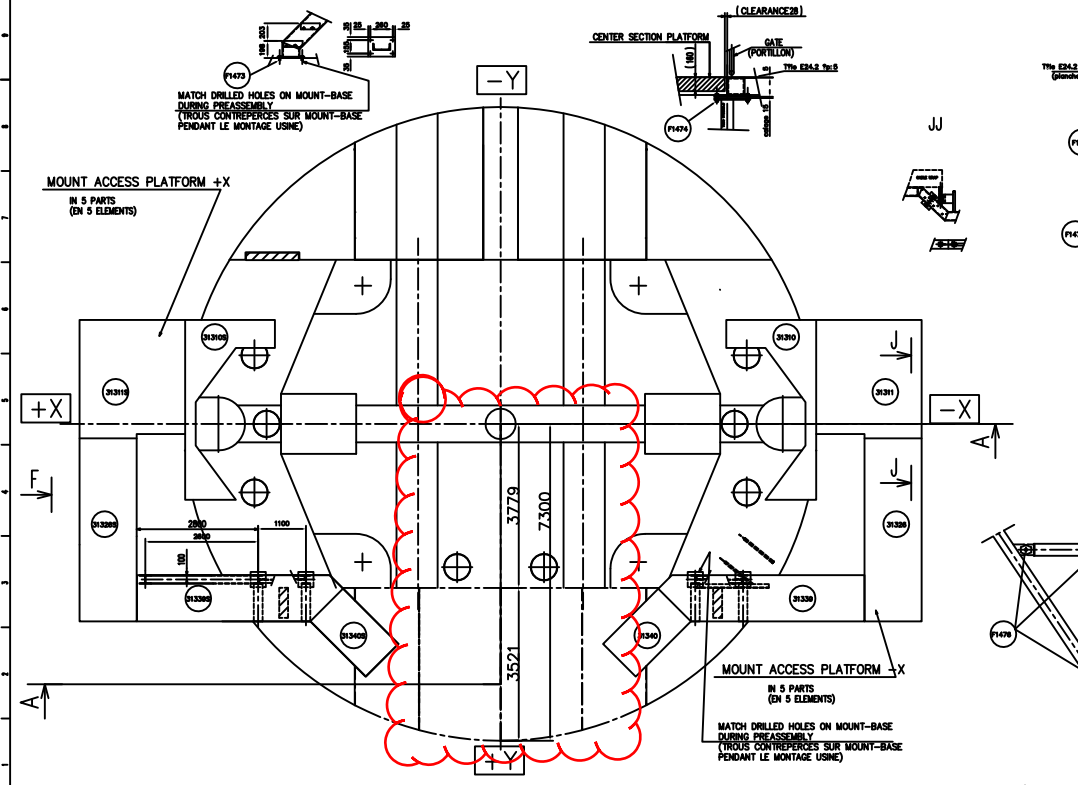

GG echelle 1/20

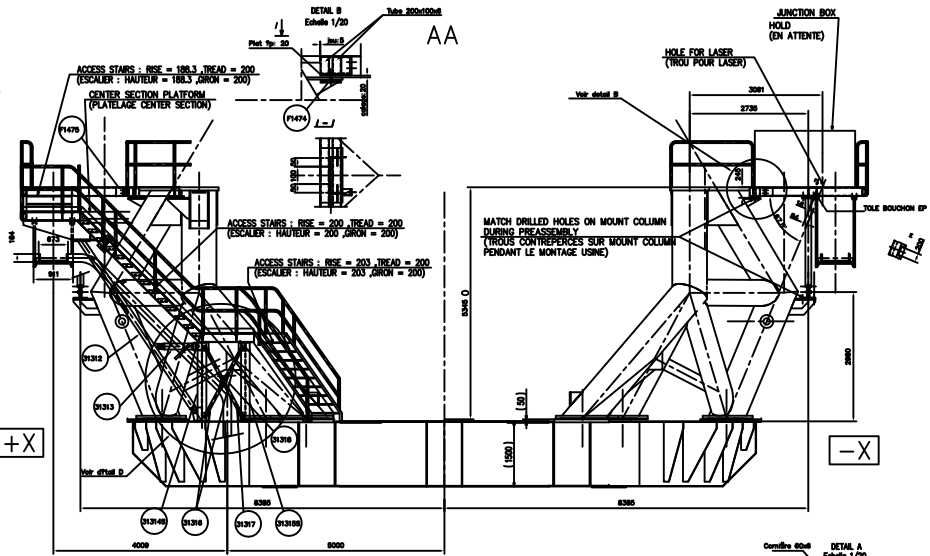

NET WEIGHT :
 • (-X) PLATFORM = 3900 Kg
 • (+X) PLATFORM = 3900 Kg

GENERAL NOTES / NOTES GÉNÉRALES
 ALL DIMENSIONS AND WEIGHTS ARE IN METERS AND KILOGRAMS UNLESS OTHERWISE SPECIFIED.
 ALL DIMENSIONS ARE TO FACE UNLESS OTHERWISE SPECIFIED.
 ALL DIMENSIONS ARE TO FACE UNLESS OTHERWISE SPECIFIED.
 ALL DIMENSIONS ARE TO FACE UNLESS OTHERWISE SPECIFIED.

GENERAL NOTES / NOTES GÉNÉRALES
 ALL DIMENSIONS AND WEIGHTS ARE IN METERS AND KILOGRAMS UNLESS OTHERWISE SPECIFIED.
 ALL DIMENSIONS ARE TO FACE UNLESS OTHERWISE SPECIFIED.
 ALL DIMENSIONS ARE TO FACE UNLESS OTHERWISE SPECIFIED.
 ALL DIMENSIONS ARE TO FACE UNLESS OTHERWISE SPECIFIED.

0	NAME OF	DATE	ISSUE	BY	AS BUILT	REVISION
1	17/04/99	ALLARD	1/000	PIE	PIERRE MATHIEU	
2	18/04/99	ALLARD	1/000	PIE	PIERRE MATHIEU	
3	19/04/99	ALLARD	1/000	PIE	PIERRE MATHIEU	
4	20/04/99	ALLARD	1/000	PIE	PIERRE MATHIEU	
5	21/04/99	ALLARD	1/000	PIE	PIERRE MATHIEU	
6	22/04/99	ALLARD	1/000	PIE	PIERRE MATHIEU	
7	23/04/99	ALLARD	1/000	PIE	PIERRE MATHIEU	
8	24/04/99	ALLARD	1/000	PIE	PIERRE MATHIEU	
9	25/04/99	ALLARD	1/000	PIE	PIERRE MATHIEU	
10	26/04/99	ALLARD	1/000	PIE	PIERRE MATHIEU	
11	27/04/99	ALLARD	1/000	PIE	PIERRE MATHIEU	
12	28/04/99	ALLARD	1/000	PIE	PIERRE MATHIEU	
13	29/04/99	ALLARD	1/000	PIE	PIERRE MATHIEU	
14	30/04/99	ALLARD	1/000	PIE	PIERRE MATHIEU	
15	01/05/99	ALLARD	1/000	PIE	PIERRE MATHIEU	
16	02/05/99	ALLARD	1/000	PIE	PIERRE MATHIEU	
17	03/05/99	ALLARD	1/000	PIE	PIERRE MATHIEU	
45	31/05/99	ALLARD	1/000	PIE	PIERRE MATHIEU	
46	01/06/99	ALLARD	1/000	PIE	PIERRE MATHIEU	
On demand et à la demande de la
 4 en part de cette notice, consultez le catalogue
 4 en part de cette notice, consultez le catalogue
 4 en part de cette notice, consultez le catalogue
 4 en part de cette notice, consultez le catalogue